

**Application Ref: NP/17/0229/S73**

<b>Case Officer</b>	Nicola Gandy		
<b>Applicant</b>	Mr D Brown, Seaside Inns Ltd		
<b>Agent</b>	Mr G Blain, Gerald Blain Ltd		
<b>Proposal</b>	Vary condition no. 2 of NP/15/0526/FUL - Alterations to Clubhouse		
<b>Site Location</b>	Buttyland Caravan & Camping Park, Manorbier, Tenby, Pembrokeshire, SA70 7SX		
<b>Grid Ref</b>	SS06909899		
<b>Date Valid</b>	24-Apr-2017	<b>Target Date</b>	18-Jun-2017

A Committee site visit took place on Monday 3<sup>rd</sup> July 2017, where Members viewed the site and the Clubhouse.

This application is reported to the Development Management Committee as the recommendation differs to the Community Council's objection to the scheme.

**Consultee Response**

**PCC - Building Regulations:** Advised the Clubhouse has not yet been signed off as construction work is on-going.

**PCNPA - Tree and Landscape Officer:** No objection

**PCC - Drainage Engineers:** No objection

**Manorbier Community Council:** Recommend Refusal - Full Council remain concerned about the increase in height of the building

**Public Response**

Neighbour notification letters were posted and a site notice erected in accordance with requirements of the Town and Country Planning (Development Management Procedure) ( Wales) Order 2012.

Three letters of objection were received from local residents. The objections are summarised below and full copies of the objections are available to inspect on the application file:-

- What part of the Town and Country Planning Act has the application been submitted under?
- Breach of conditions 3 & 4 of NP/15/0526/FUL
- Plans should be provided showing the height of the building as constructed, showing levels, ramps retaining walls
- Alterations made to barn at rear of Clubhouse
- Drainage Concerns
- Details of landscaping, access road and footpaths and outside seating areas should be provided.
- Hours of operation
- Details of external lighting/extraction units etc. should be provided

- Use class of the building/ open to the general public
- Plan should include all land owned by applicant
- Querying licence operating hours

### **Policies considered**

Please note that these policies can be viewed on the Policies page Pembrokeshire Coast National Park website -

<http://www.pembrokeshirecoast.org.uk/default.asp?PID=549>

LDP Policy 01 - National Park Purposes and Duty

LDP Policy 06 - Rural Centres

LDP Policy 08 - Special Qualities

LDP Policy 15 - Conservation of the Pembrokeshire Coast National Park

LDP Policy 29 - Sustainable Design

LDP Policy 30 - Amenity

LDP Policy 35 - Visitor Economy

LDP Policy 43 - Protection of Employment Sites and Buildings

LDP Policy 53 - Impacts on traffic

### **Constraints**

LDP Allocation

LDP Mineral Safeguard

Historic Landscape

Potential for surface water flooding

LDP Centre:50pc aff housing;30 units/ha

Recreation Character Areas

Landscape Character Assessment

### **Officer's Appraisal**

#### **Description of Proposal and Site**

The application seeks permission to amend condition 2 of NP/15/0523/FUL for the erection of a Clubhouse. Condition 2 of NP/15/0523/FUL tied the permission to the approved plans, the building as constructed is not in accordance with the approved plans and this application seeks to regularise the following alterations:-

- Increase in height of building by 20cm.
- Erection of a first floor balcony with fire escape staircase
- Minor alteration to internal layout arrangement

The application site is a long established caravan site located on the eastern flank of Station Road running north toward Manorbier Station. The caravan site area straddles the Rural Centre boundary, as defined by Policy 6 of the Local

Development Plan, with the eastern part of the site falling in the open countryside. The clubhouse is situated within the Rural Centre and within the existing curtilage of the caravan site.

There are a number of other buildings on the site including a bungalow, reception building and toilet block. The main body of caravans are located on the land to the south of these buildings. To the north are residential properties; to the west is a garden centre and holiday park; and to the east are open fields.

### **Relevant Planning History**

NP/17/117/NMA – Non material amendment alteration in fenestration material – Approved 8/03/2017

NP/17/171/NMA – Non material Amendment – Increase in height of building – Withdrawn 6/04/2017

NP/16/0502/FUL – Amendment to NP\*/15/0526/FUL comprising change of use of first floor staff/managers accommodation to guest rooms and alterations to clubhouse - Withdraw 6<sup>th</sup> February 2017.

NP/15/0526/FUL – New Club House – Approved 16th December 2015.

### **Key Issues**

The application raises the following planning matters:

- Policy
- Siting, Design and Impact upon the Special Qualities of the National Park
- Access and parking
- Highway Safety
- Landscaping
- Biodiversity
- Drainage
- Response to consultation responses

#### *Policy:*

The application site is located within Manorbier, which is identified in the Local Development Plan (LDP) as being a Rural Centre, as such, Policy 6 applies. Policy 6 of the LDP states that in a Rural Centre, small scale employment development will be encouraged and one of the land use priorities is to protect and enhance a Rural Centre's range of facilities. Concerns have been expressed by local residents in respect of the use of the Clubhouse by members of the public, however, there were no restrictive conditions attached to the original approval (NP/15/0526/FUL refers) in terms of usage by the public and, as such, the principle of a Clubhouse being open to the general public at this location has already been approved. Furthermore, the use of the Clubhouse by members of the public will result in the building being a

facility to serve the wider community and Rural Centre, therefore, the development is considered to comply with the land use priorities of Policy 6 of the LDP.

Policy 40 of the LDP states that the development of retail and other facilities on caravan sites will be permitted where the facility is not already available in the vicinity, the scale is not out of keeping and the vitality and viability of retailing and services of nearby Centres are not adversely affected. In the supporting text to Policy 40 it is accepted that sites would require good quality facilities, and for larger sites, these can be considered in circumstances where such facilities are lacking in the immediate locality. In this instance the application is to make amendments to a previously approved Clubhouse, consequently, the principle of the Clubhouse to serve both the caravan site and the wider public at this location has already been established and accepted.

#### *Siting, Design and Impact upon the Special Qualities of the National Park*

Policy 8 of the LDP is a strategic policy which refers to the special qualities of the National Park and list priorities to ensure that these special qualities are protected. Policy 15 of the LDP refers to the conservation of the Pembrokeshire Coast National Park, with criterion (b) resisting development that would be insensitively and unsympathetically sited within the landscape.

The application seeks approval for an increase of 0.2m to the overall height of the previously approved building. The Clubhouse is set back from the highway some 25m, therefore, when viewed from public viewing points the building generally appears as previously approved and the alteration to the height does not have an adverse impact on the visual amenities of the immediate area or the on the special qualities of the National Park.

The application also includes the additional of a balcony with a fire escape staircase. These are located to the rear and are screened from the neighbouring properties and wider public views to the north by the rear two storey projection.

Having regard to the above the amendments are considered not to give rise to any overriding concerns in respect of the buildings impact on the visual amenities of the immediate area or on the special qualities of the National Park.

#### *Amenity and Privacy:*

Policy 30 of the LDP seeks to avoid development that is inappropriate for where people live or visit, of an incompatible scale with its surroundings, leads to an increase in traffic or noise or odour which has a significant adverse impact.

There are a number of residential properties located to the north and north- west of the application site. Whilst the clubhouse is 0.2m higher than previously approved, given the distance of 15m between the Clubhouse and the nearest residential properties it is considered that the marginal increase in height does not result in any adverse overshadowing or dominance.

In respect of the balcony and external fire escape, these are screened from the neighbouring properties by the two storey rear projection and views from the balcony are restricted to the existing caravan site, consequently the balcony is not considered to raise any concerns in respect of privacy.

The Environmental Health Officer at Pembrokeshire County Council has been consulted on the application, and has raised no comments. A condition is recommended requiring details of extraction equipment to be submitted to and approved by the Local Planning Authority in order to protect residential amenity. A further condition limiting the opening hours in line with the opening hours permitted by the licence is also recommended.

*Access and Parking:*

The existing access to the main road will be unaltered and parking will be provided on an existing hardstanding within the site. The Highways Officer at Pembrokeshire County Council has assessed the scheme and offered no objection in terms of highway safety or parking provision.

The car park and footpaths are shown on the submitted plans.

*Landscaping:*

There is a leylandi hedge along the northern boundary of the site, part of which has recently been removed. A requirement of planning permission NP/15/0526/FUL was to retain and protect all trees on site, however the applicant has advised that it was damaged during construction and removed. A breach of condition notice has been served and a replacement boundary wall has been erected. Discussions are on-going in respect of gaining access to render the northern side of the wall.

*Biodiversity:*

The Authority's Ecologist had no comments. However, on the previous approval for the Clubhouse a condition was attached requiring a scheme for external lighting, consequently, a similar condition is recommended for this application.

*Land Drainage:*

The Drainage Officer and Building Regulations department at Pembrokeshire County Council and Dwr Cymru have been consulted on the application. No responses have been received at the time of writing this report. However, there was no objection on drainage grounds on the original application (NP/15/0526/FUL refers) or the withdrawn application (NP/16/0502/FUL refers).

Concerns have been raised by local residents in regard to the drainage of the site. A condition is recommended requiring details of foul drainage to be submitted to and agreed in writing by the Local Planning Authority prior to the beneficial use of the Clubhouse.

*Response to consultation responses:*

The majority of the objections raised have been addressed in the main body of the report, however, the following points address the other objections raised:-

- The application has been submitted under Section 73 of the Town and Country Planning Act 1990
- The agent has provided an amended plan to include additional land owned by the applicant
- The original plans (NP/15/0526/FUL) for the Clubhouse show the proposed building as being on a flat site and levels on site have been increased to this effect. The agent has advised that no details of original levels were available, however, the approved plans show the Clubhouse on a level site and it has been constructed in this manner. No ramps or retaining walls are proposed.
- The agent has advised that the buildings to the rear of the application site were not originally surveyed as they were not part of the development, as such, part of the barn to the rear had to be removed to accommodate the Clubhouse. Planning permission is not required for the removal of a small part of the barn.
- The Clubhouse is Sui Generis and does not fall within one of the categories in the Town and Country Planning (Use Class) Order 1987.
- In respect of the hours of operation, the application seeks to regularised alterations to the physical form of the building rather than the use of the building, however, as an external balcony area is proposed a condition will be attached to any permission granted restricting the hours of operation in line with those granted as part of the licence granted by PCC.

## **Conclusion**

Notwithstanding the objections raised, following consideration of the policies contained within the Local Development Plan and having regard to all material planning considerations it is considered that the amendments to the Clubhouse do not have a detrimental impact on the special qualities of the National Park or neighbouring amenity. The application is, therefore, recommended for approval subject to conditions.

## **Recommendation**

### **APPROVE, subject to the following conditions:**

1. The development shall be carried out in accordance with the following approved plans and documents: Location Plan Drawing No. 000 (Received 23rd May 2017), Existing and Proposed Block Plans Drawing No. 100 (received 23rd May 2017), Proposed New Club House Plan Drawing No.

101A (received 12th April 2017), Proposed New Club House Elevations Drawing No. 102 (received 23rd May 2017) .

**Reason:** In order to be clear on the approved scheme of development in the interests of protecting visual amenity and the special qualities of the National Park. Policy: Local Development Plan – Policies 1 (National Park Purposes and Duty), 8 (Special Qualities), 15 (Conservation of the Pembrokeshire Coast National Park) and 29 (Sustainable Design).

2. Prior to the beneficial use of the building details for kitchen extractor systems, external plant and any associated flue(s) and equipment shall be submitted to and approved in writing by the Local Planning Authority. The details shall specify the proposed measures to attenuate noise and odour from the extractor system. The noise and odour control scheme as approved shall be installed to the satisfaction of the Local Planning Authority prior to commencement of use.

**Reason:** To protect the amenity of local residents from odour/fumes and noise. Policy: Local Development Plan – Policy 30 (Amenity)

3. Prior to the erection of external lighting, a light mitigation strategy, including measures to reduce light spillage onto foraging habitats for bats, shall be submitted to and approved in writing by the local planning authority. The development shall be carried out in accordance with the approved details.  
**Reason:** To ensure that animal and plant species and habitats listed under the Conservation of Habitats and Species Regulations 2010 are adequately protected, and to protect and enhance the character and appearance of the site and its setting within the Pembrokeshire Coast National Park. Policy: Local Development Plan – Policies 1 (National Park Purposes and Duty), 8 (Special Qualities), 11 (Protection of Biodiversity) and 15 (Conservation of the Pembrokeshire Coast National Park).

4. The 'managers accommodation' identified on drawing Number 101 shall be used for the purposes of the manager and staff as a rest room as set out in e-mail dated 15th December, 2015 part of planning permission NP/15/0526/FUL and shall specifically not be used as a separate residential unit.

**Reason:** The application provides insufficient information to justify this accommodation and the accommodation shown provides insufficient amenity space. Policy: Local Development Plan - Policy 30 (Amenity).

5. All remaining hedgebanks, natural stone boundary walls and tree/shrub growth shall be retained and protected at all times.

**Reason:** In the interests of maintaining a satisfactory scheme of landscaping and to protect the visual amenity of the area. Policy: Local Development Plan - Policy 15 (Conservation of the Pembrokeshire Coast National Park).

6. Prior to the beneficial use of the Clubhouse a scheme for the comprehensive and integrated drainage of the site, showing how foul drainage will be dealt with, shall be submitted to and approved in writing by the Local Planning Authority. The drainage scheme shall be implemented as approved and prior to the beneficial use of the Clubhouse.

**Reason:** To ensure that effective drainage facilities are provided for the development and that no adverse impact occurs to the environment. Policy: Local Development Plan – Policy 29 (Sustainable Design).


7. The Clubhouse hereby approved shall not be open to customers outside the following hours:-

Monday – Sunday 0800 - 0000hrs


Bank holidays 0800 - 0100hrs

**Reason:** In the interests of residential amenity. Policy: Local Development Plan – Policy 30(Amenity).



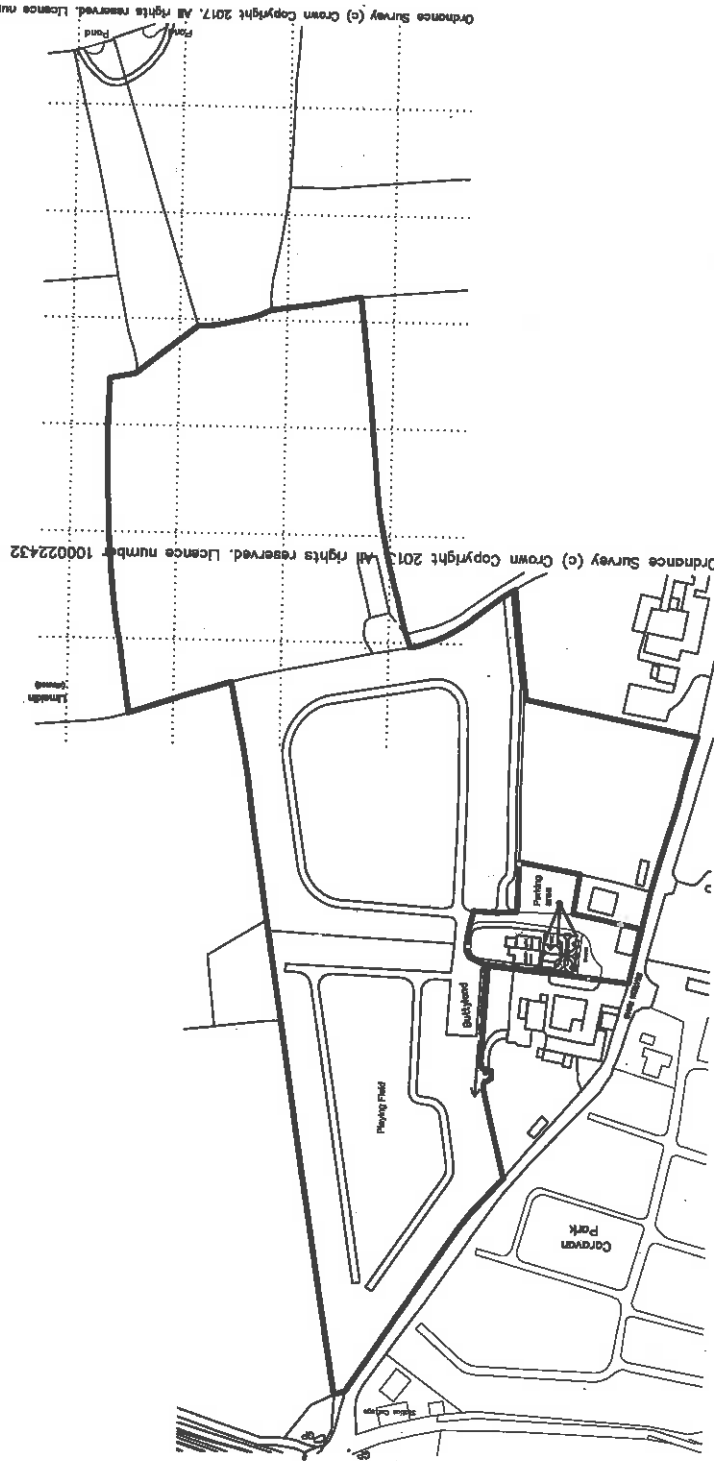

NP 17 2 29

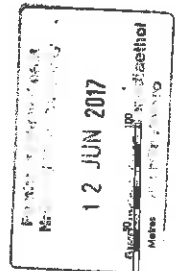


AMENDED

REV J BLUE LINE AMENDED 09/06/2017  
 REV H BLUE LINE AMENDED 23/05/2017  
 REV G BLUE LINE AMENDED 31/03/2017

DRAWN BY:		MR. D. BROWN	
CHECKED BY:		1/2500	
DATE:		08/09/2018	
SCALE:		AS	

**GERALD BLAIN**  
 ARCHITECTURAL & PLANNING CONSULTANTS  
 49 - 50 New Road, Chippenham, Wiltshire SN15 1HL  
 15 St Johns Street, Windenog, Carmarthen SA34 0AN  
 T: 01249 400800/01994 240366 M: 07970 420322

# PROPOSED CLUBHOUSE LOCATION PLAN

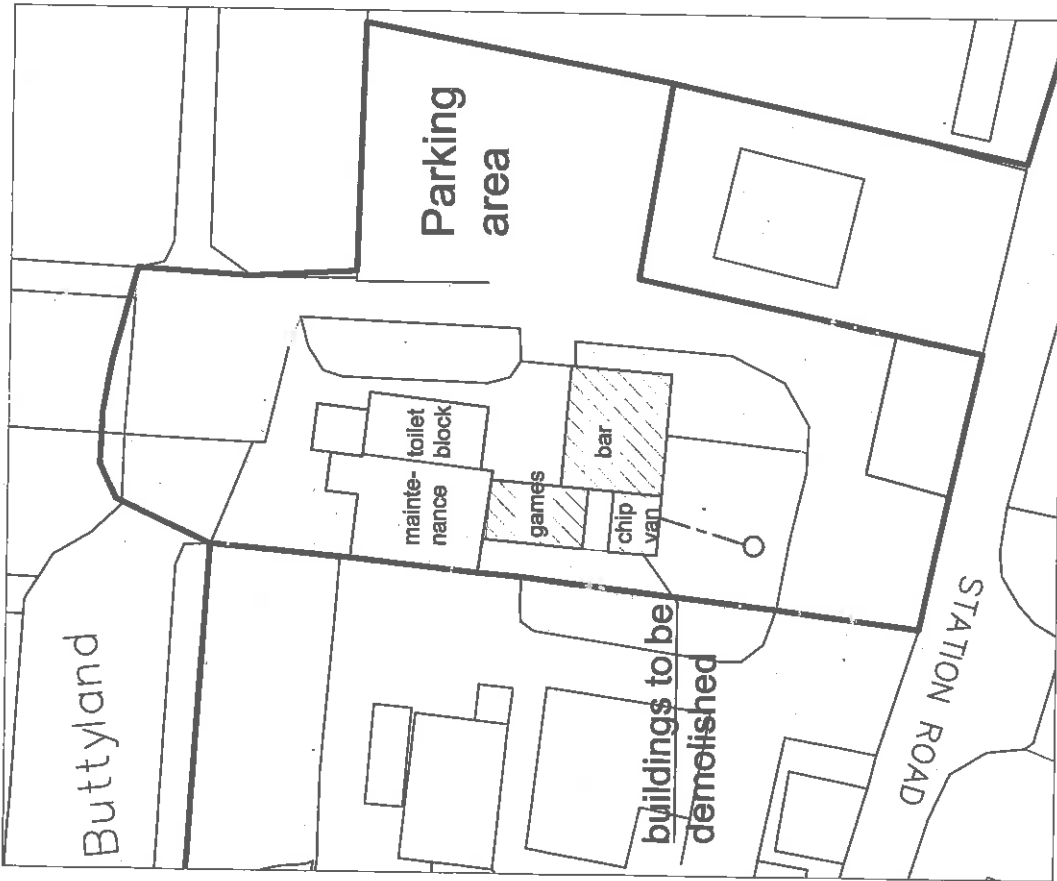


**EXISTING**




Metres

**PROPOSED CLUBHOUSE  
BLOCK PLANS**

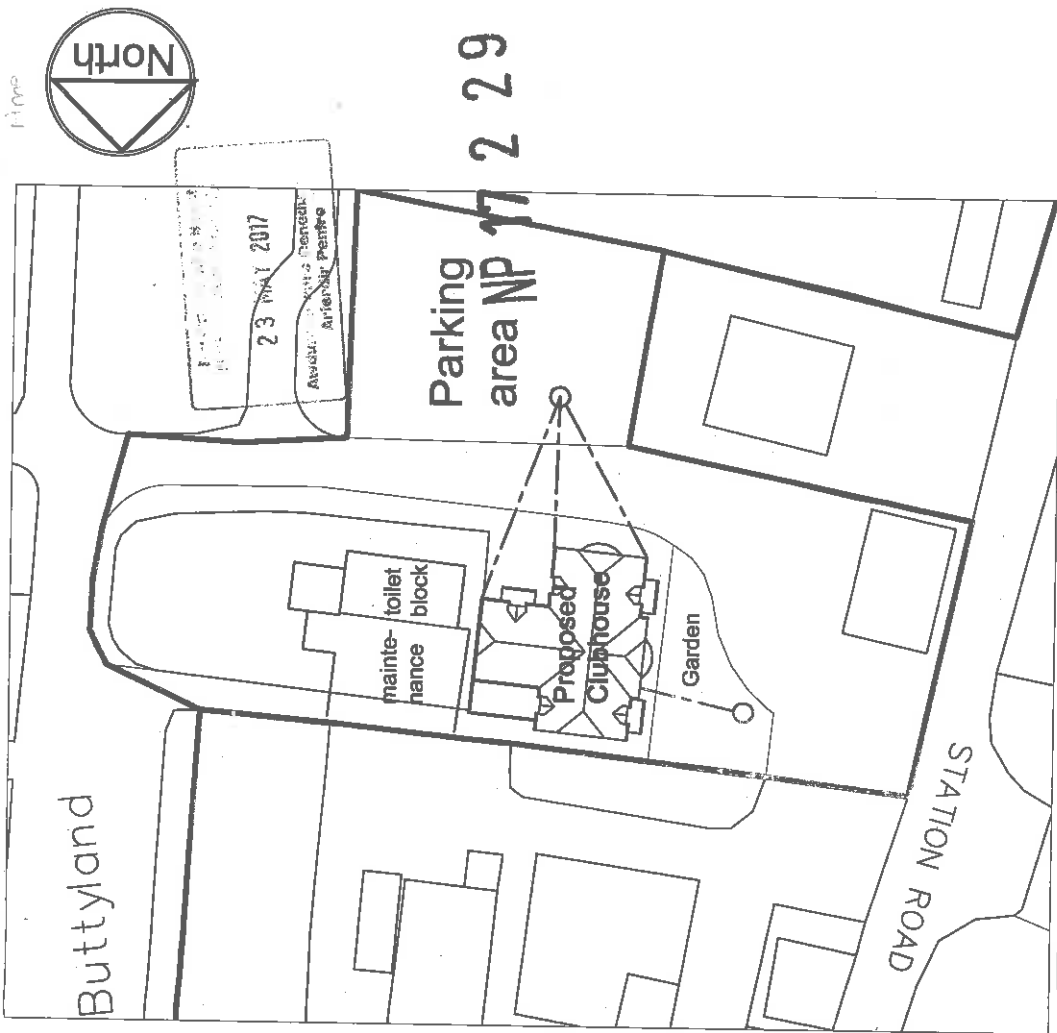


**PROPOSED**

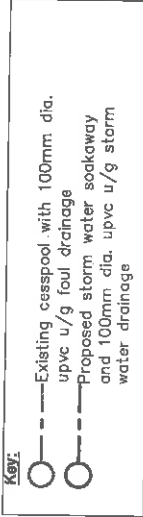


**GERARD BLAIN**  
A S S O C I A T E S

ARCHITECTURAL & PLANNING CONSULTANTS  
49 - 50 New Road, Chippenham, Wiltshire SN15 4HL  
15 St Johns Street, Whitland, Carmarthenshire SA34 0AN  
T: 01249 400800/01994 240366 M: 07970 420322

JOB:		PROPOSED REDEVELOPMENT OF CLUBHOUSE STATION RD, MANUBRIDGE	
BLOCK TITLE:		BLOCK PLANS VEGETATION AND PROPOSED	
DATE:	100	DATE:	08/09/2015
DRAWN BY:	MB	CHECKED BY:	
SCALE:	1/500	SCALE:	1/500
DRAWN BY:		MR. D. BROWN	

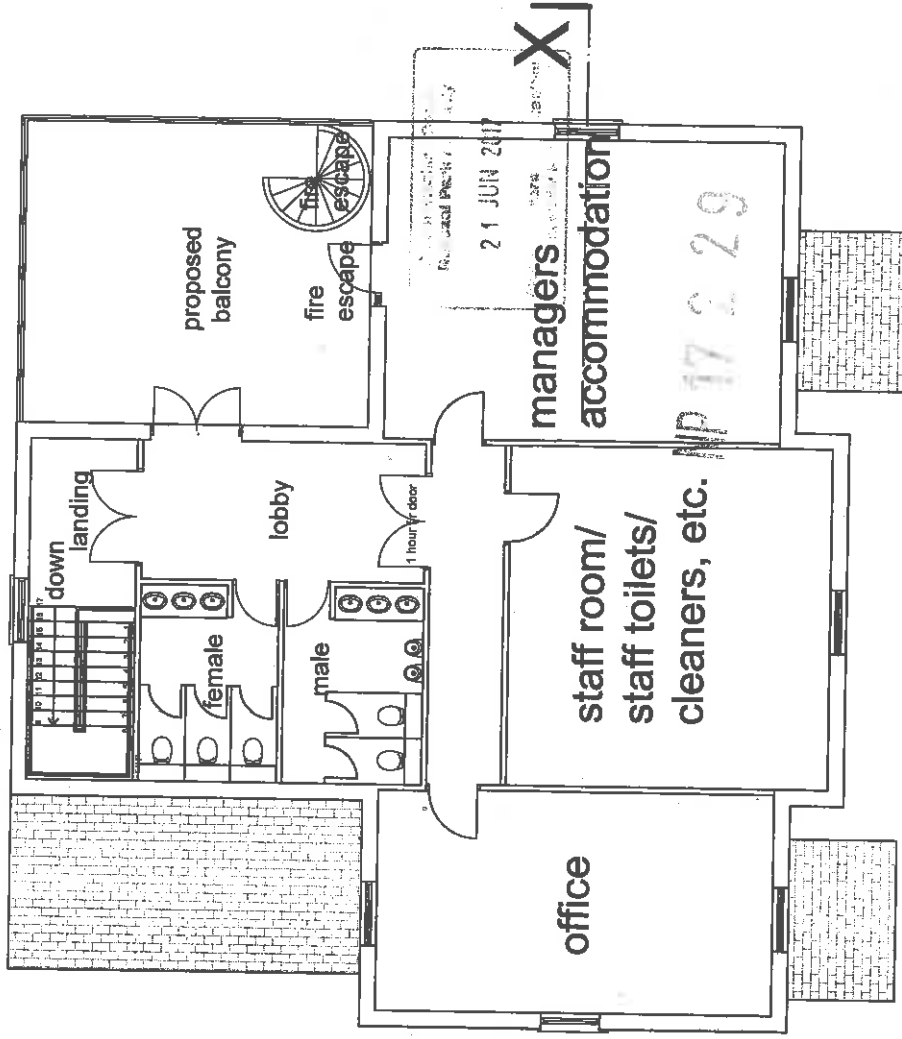

first floor plan

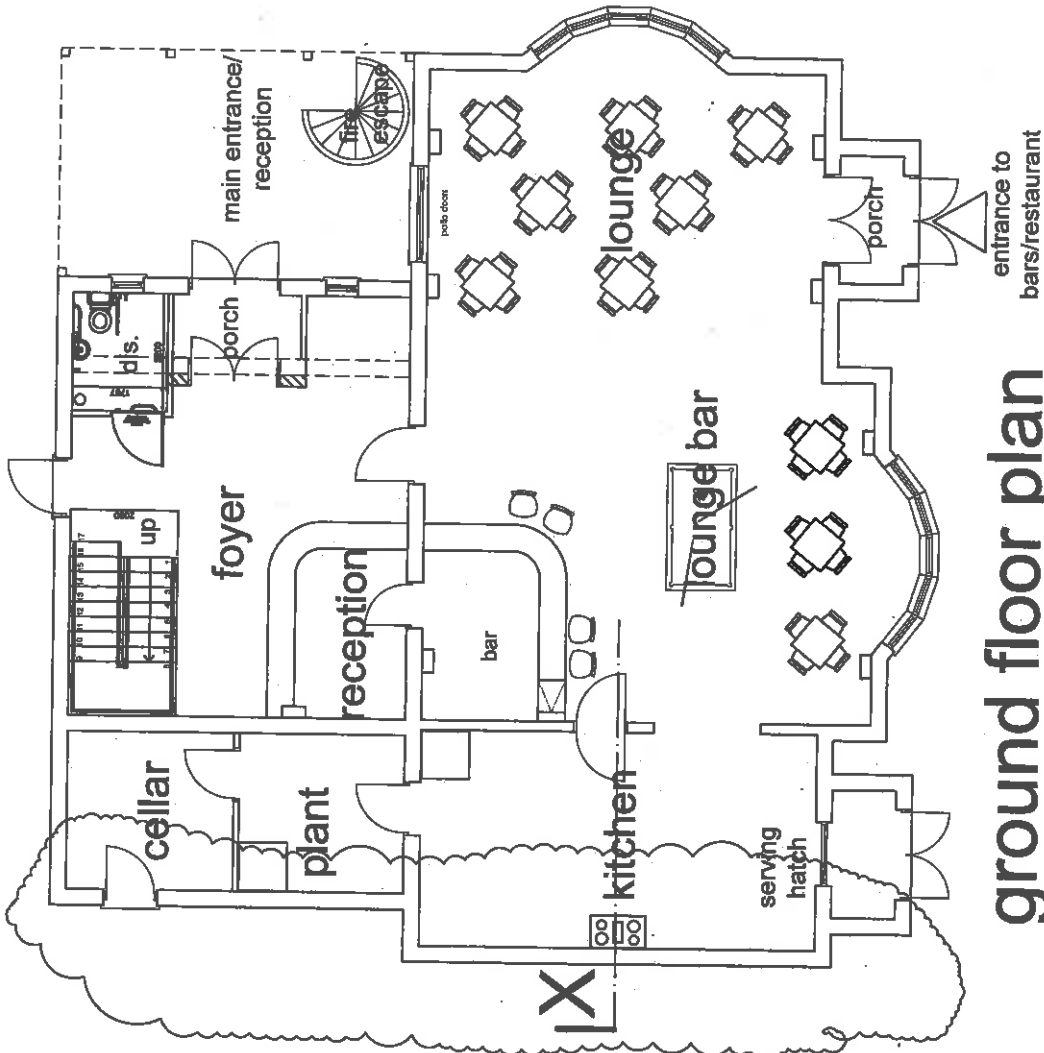

ground floor plan



REVISED  
 Item 5g)  
 REV J WINDOW AMENDED 19/06/2017  
 REV B BALCONY ADDED & EXTERIOR AMENDMENTS  
 31/03/2017

JOB:		PROPOSED REDEVELOPMENT OF CLUBHOUSE AT BUTTYLAND CARAVAN PARK, STATION RD, MANORBIER	
DATE:	08/09/2015	SCALE:	1/100
DRAWN BY:	MB	DATE:	AS
CHECKED BY:			
DESIGNED BY:			
PROJECT TITLE:	PROPOSED NEW CLUB HOUSE PLANS		
PROJECT NO:	101A		
CLIENT:	MR. D. BROWN		

**GERALD BLAIN**  
 ARCHITECTURAL & PLANNING CONSULTANTS  
 49 - 50 New Road, Chippenham, Wiltshire SN15 1HL  
 45 St Johns Street, Whitland, Carmarthenshire SA34 0AN  


A S S O C I A T E S

EXTERNAL MATERIALS  
 ROOF - MARLEY PLAIN SLATE GREY CONCRETE TILE  
 FASCIA & RAINWATER GOODS - WHITE/BROWN UPVC  
 WALLS - PAINTED RENDER & STONE DETAILING  
 WINDOWS & DOORS - WHITE UPVC


0 5m




west (road) elevation

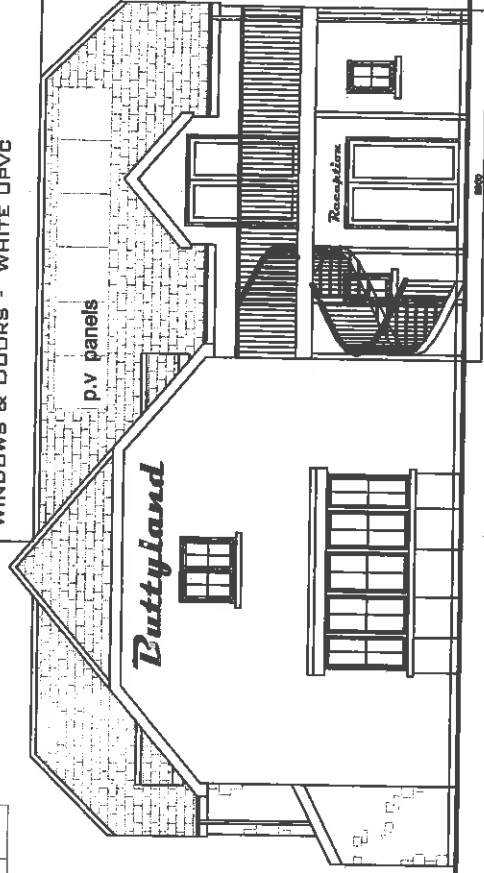

south (front) elevation

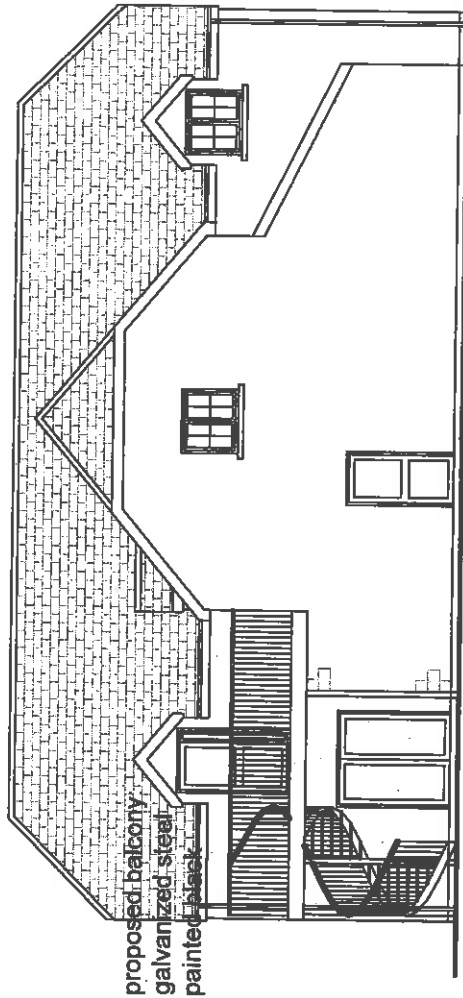

east elevation

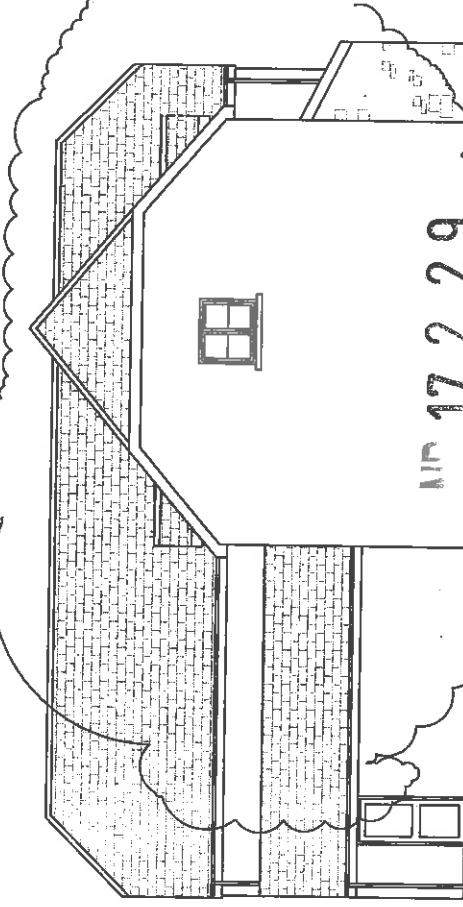

north elevation

Item 5g)

REV H WINDOWS AMENDED 09/06/2017  
 REV G BALCONY AMENDED 22/05/2015  
 REV B BALCONY AMENDED 22/05/2015  
 31505-2017  
 AMSNSET

JOB: PROPOSED REDEVELOPMENT OF CLUBHOUSE AT BUTTYLAND GARDEN PARK, STATION RD, MANDRIBER	
DATE: 17/02/2015	DATE: 08/09/2015
DRAWN BY: MB	CHECKED BY:
SUN: M. D. BROWN	SCALE: 1/100
	AS

**GERALD BLAIN**  
 ARCHITECTURAL & PLANNING CONSULTANTS  
 49 - 50 New Road, Chippenham, Wiltshire SN15 4HL  
 15 St Johns Street, Whitland, Carmarthenshire SA34 0AN  
 T: 01249 400900/01994 240366 M: 07970 420322

12 JUN 2017



**PROPOSED CLUBHOUSE**

**EXTERNAL MATERIALS**

ROOF - MARLEY PLAIN SLATE  
 GREY CONCRETE TILE  
 FASCIA & RAINWATER GOODS - WHITE/BLACK UPVC  
 WALLS - PAINTED RENDER & STONE DETAILING  
 WINDOWS & DOORS - WHITE UPVC



12 APR 2017

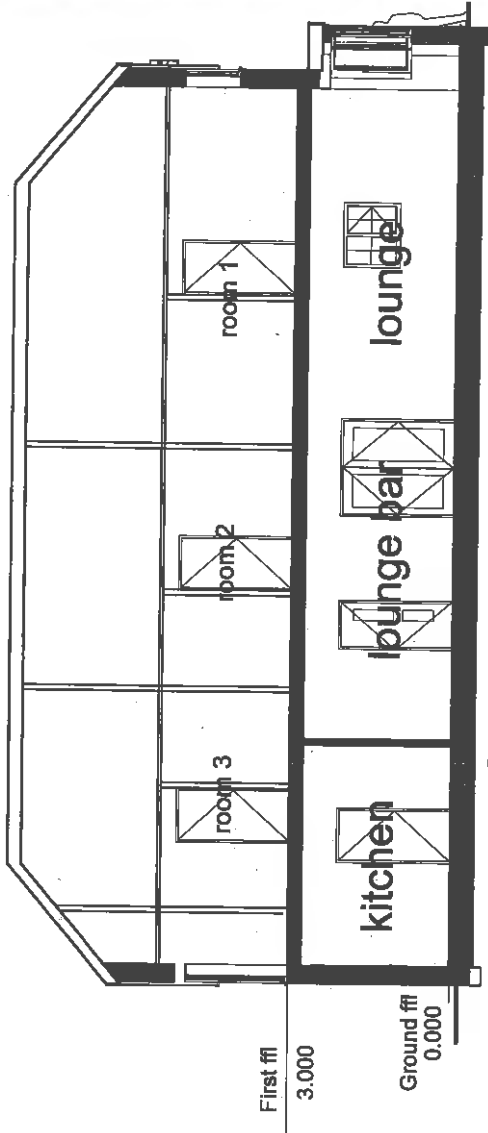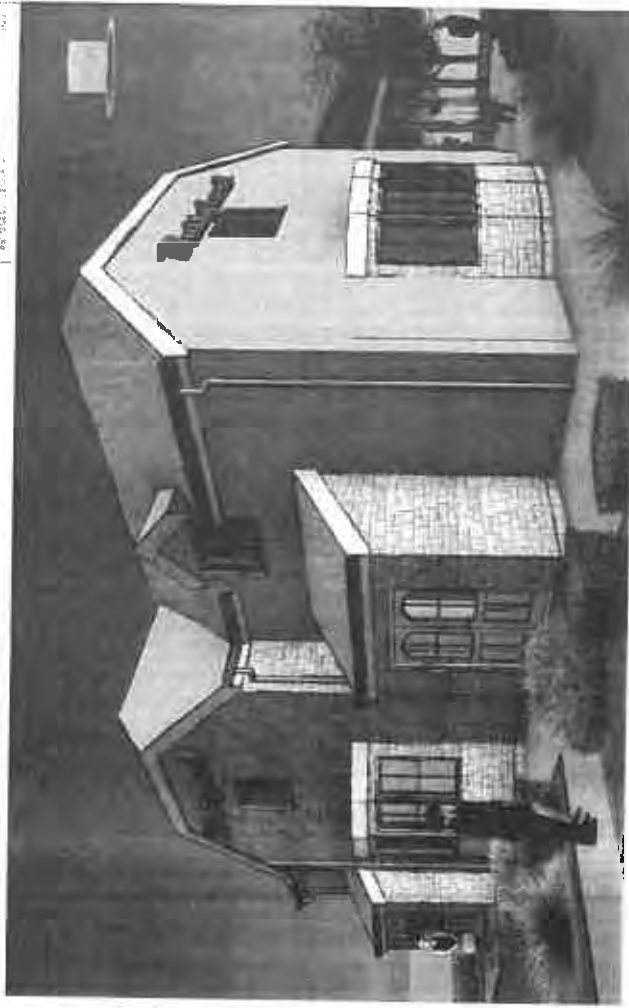

**section X-X**

**3D impression**

MP 17 2 29

Item 5g)

REV IS BALCONY ADDED & EXTERIOR AMENDMENTS  
 31/03/2017

JOB:		PROPOSED DEVELOPMENT OF CLUBHOUSE AT BUTYLAND CARRIAGE PARK, STATION RD, MANDRILLER	
CWE TITLE:		NEW CLUBHOUSE	
DRAWN BY:		MR. D. BROWN	
CHECKED BY:		1/100	
DATE:		08/09/2015	
PROJECT NO.:		17/2/29	
SCALE:		A3	

**GERALD BLAIN**  
 ARCHITECTURAL & PLANNING CONSULTANTS  
 49 - 50 New Road, Chippingham, Wiltshire SN15 1HL  
 15 St Johns Street, Whitland, Carmarthenshire SA34 0AN  
 T: 01249 400800/01994 240366 M: 07970 420322